

STONE BOUND LOCATIONS
MASS STATE PLANE NAD 83
PLAN LOCATION

SBDO1	1	3021456.139	684738.6399
SBDO2	2	3021447.7207	684757.1015
SBDO3	3	3021431.6214	684773.2467
SBDO4	4	3021382.3309	684781.6399
SBDO5	5	3021473.381	685018.0606
SBDO6	6	3021424.9629	685026.4532
SBDO7	7	3021392.6615	685196.3819
SBDO8	8	3021366.4125	685353.7667
SBDO9	9	3021340.6214	685513.2467
SBDO10	10	3021208.9242	685250.9857
SBDO11	11	3021276.9697	685478.0266
SBDO12	12	3021271.1695	685527.7231
SBDO13	13	3021429.2971	685494.8198
SBDO14	14	3021423.7969	685544.6155
SBDO15	15	3021554.1799	685768.1109
SBDO16	16	3021512.9967	685739.7526
SBDO17	17	3021479.6627	685876.3159
SBDO18	18	3021473.381	685918.0606
SBDO19	19	3022327.9685	686135.2540
SBDO20	20	3022353.3790	685947.5750
SBDO21	21	3022420.5900	685869.2027
SBDO22	22	3022371.6278	685859.0724

FIELD LOCATION

SBDO1	2	3021456.070	684738.6438
SBDO2	1	3021347.5945	684575.1718
SBDO3	3	3021431.6151	684783.2382
SBDO4	4	3021382.2437	684781.5976
SBDO5	5	3021473.5125	685017.9770
SBDO6	6	3021423.9629	685026.4474
SBDO7	7	3021392.6311	685196.3624
SBDO8	8	3021366.3842	685193.3700
SBDO9	9	3021402.0212	685295.9836
SBDO10	10	3021208.8399	685250.9534
SBDO11	11	3021276.6452	685477.9592
SBDO12	12	3021271.5573	685527.6843
SBDO13	13	3021429.2223	685494.8847
SBDO14	14	3021423.7421	685544.8894
SBDO15	15	3021554.1401	685768.1577
SBDO16	16	3021512.9662	685739.8063
SBDO17	17	3021479.5806	685976.4038
SBDO18	18	3021479.5806	685976.4038
SBDO19	19	3022328.1206	686135.8260
SBDO20	20	3022353.1603	685947.3760
SBDO21	21	3022420.5821	685869.2878
SBDO22	22	3022371.6369	685859.1548

PLAN REFERENCE

DEFINITIVE SUBDIVISION RECORD PLANS RAIL TREE HILL ESTATES
WESTFORD, MA BY DIPRETE MARCHIONDA & ASSOC., INC. DATED
MARCH 1988, REVISED TO 4/29/88, RECORDED AT THE DIDDLESEX
NORTH DISTRICT REGISTRY OF DEEDS IN PLAN BOOK 167 PLAN 46.

LEGEND

☐ SBDH 6"x 6" GRANITE STONEBOUND

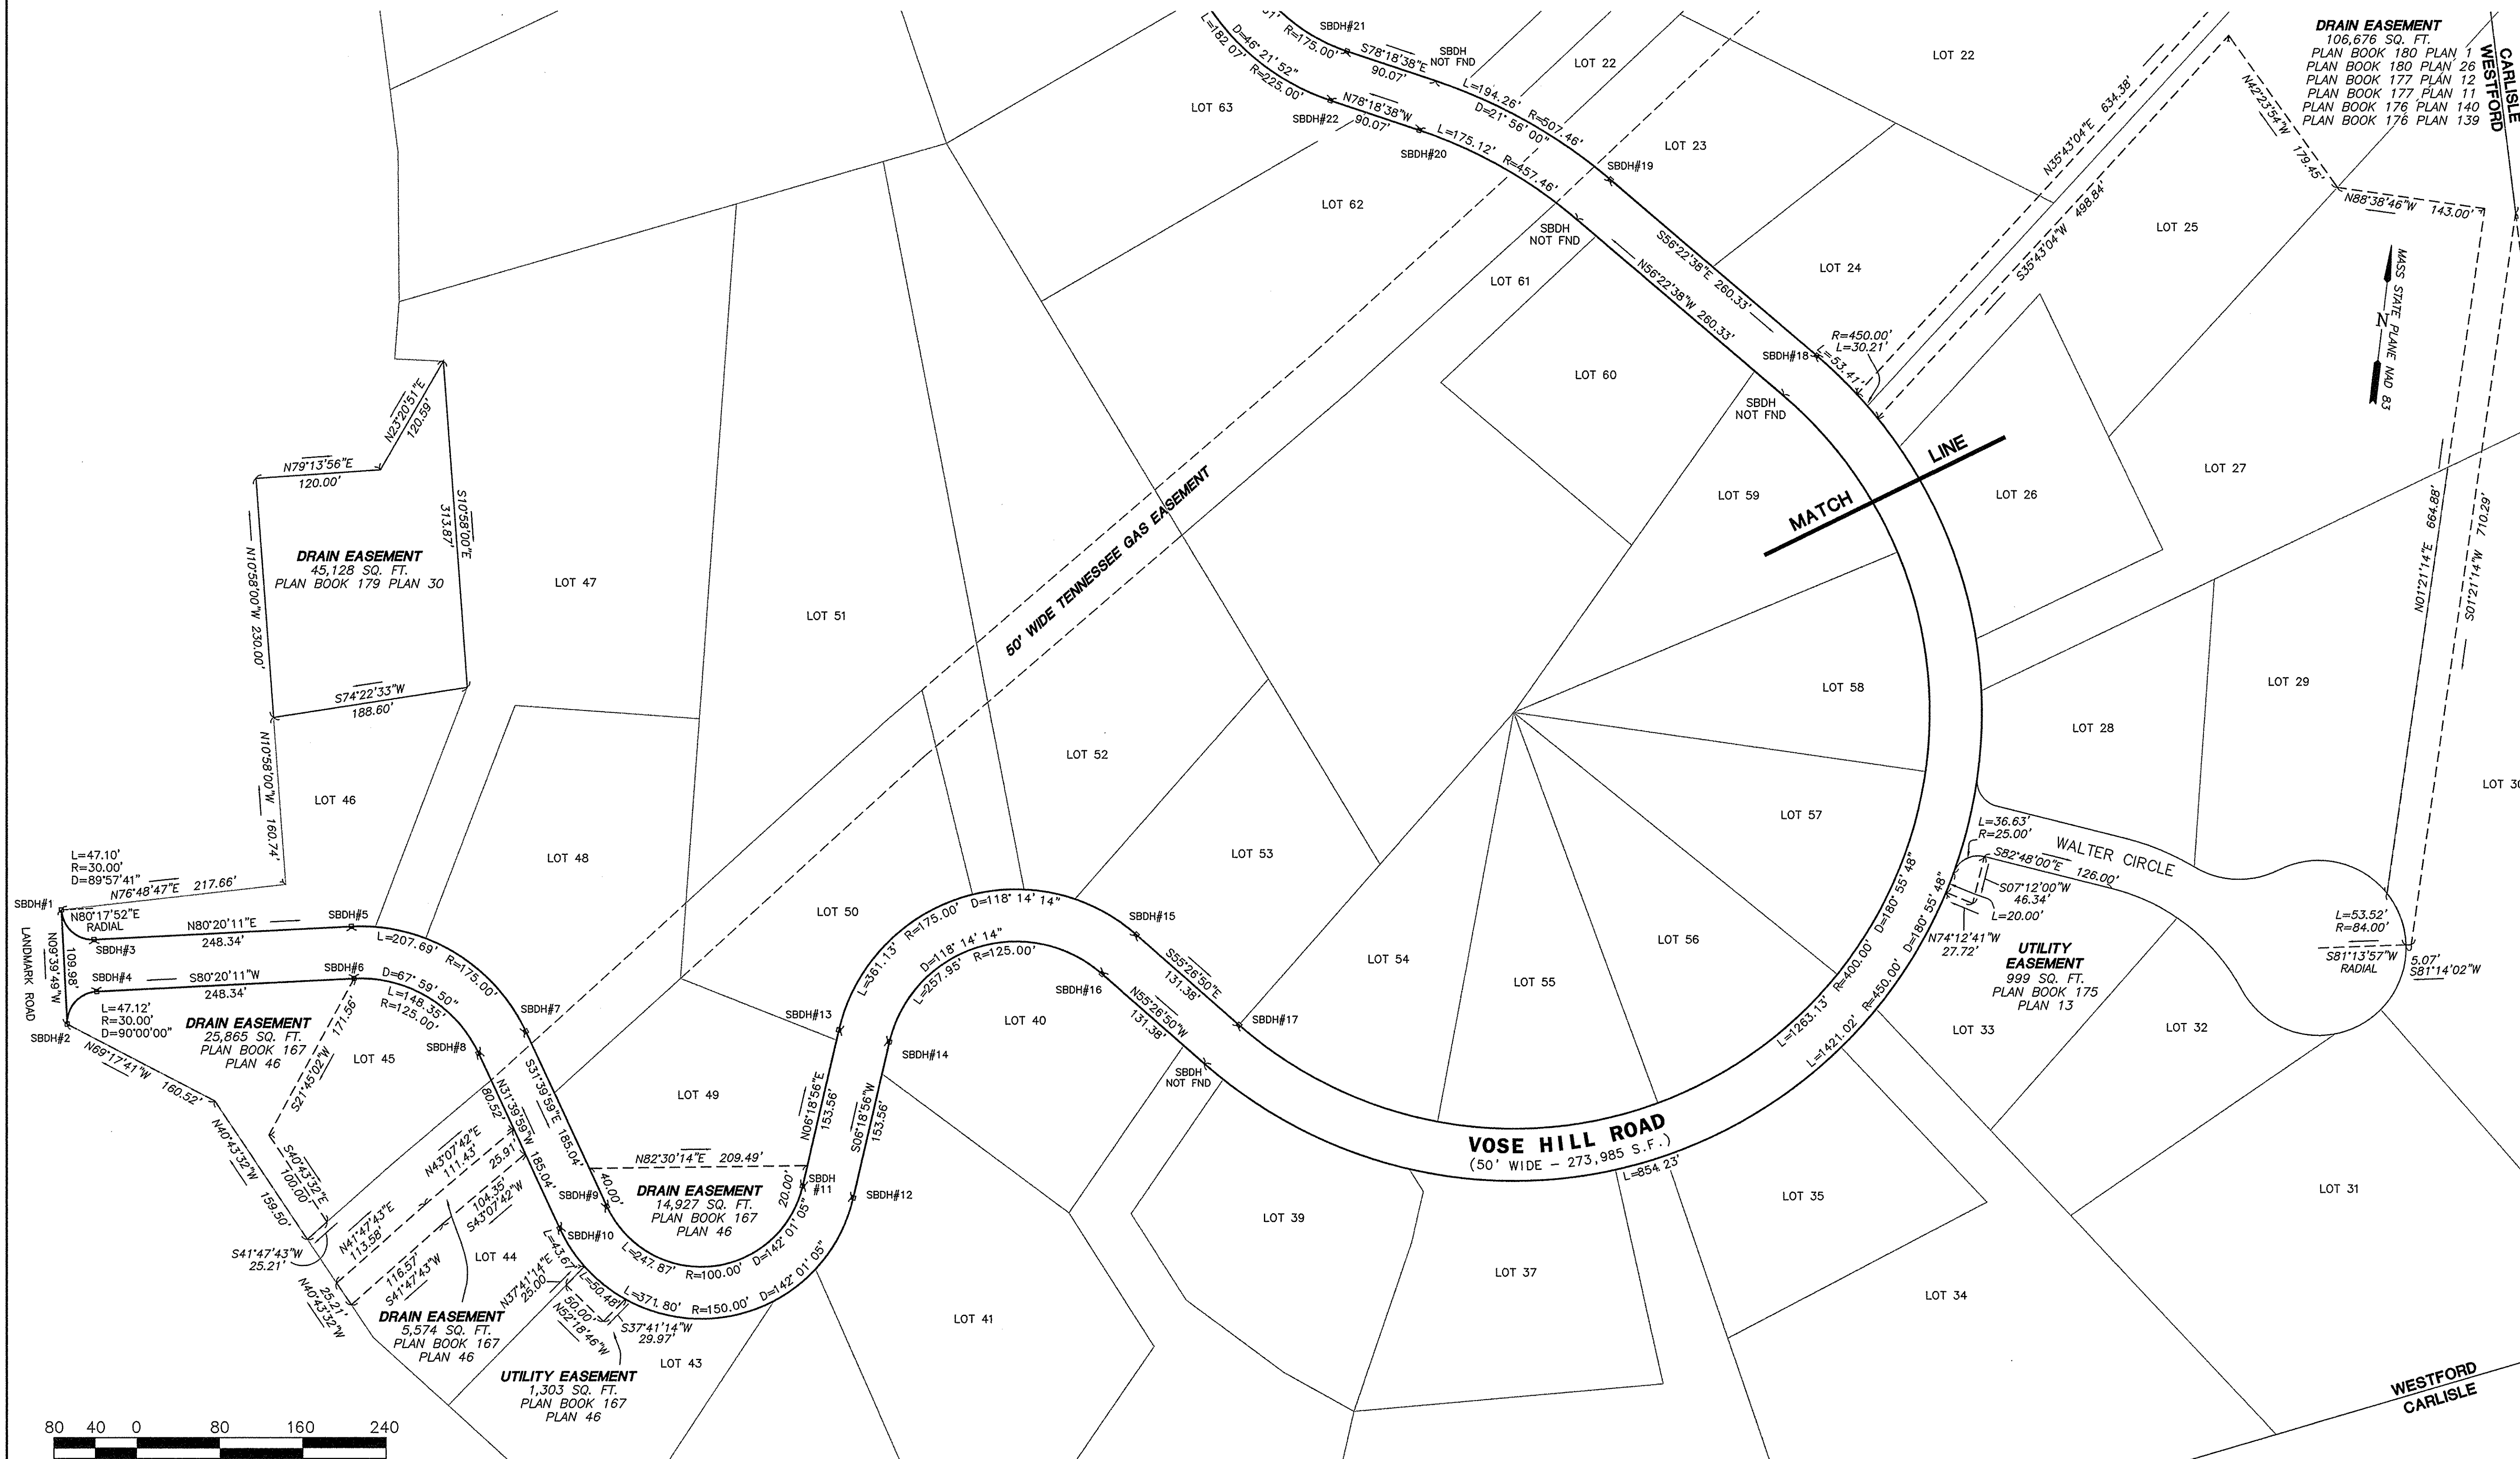
CERTIFICATION

"I CERTIFY THAT THIS PLAN CONFORMS TO THE RULES AND REGULATIONS OF THE REGISTERS OF DEEDS OF THE COMMONWEALTH OF MASSACHUSETTS.

"I HEREBY CERTIFY THAT THE PROPERTY LINES SHOWN HEREON ARE THE ONES DIVIDING EXISTING OWNERSHIPS AND THE LINES OF STREETS AND WAYS SHOWN ARE THOSE OF PUBLIC OR PRIVATE STREETS OR WAYS ALREADY ESTABLISHED AND THAT NO NEW LINES FOR DIVISION OF EXISTING OWNERSHIP OR FOR NEW WAYS ARE SHOWN."

STEPHEN M. MELESCIUC, P.L.S. 39049

DATE _____

[illegible]

STREET ACCEPTANCE PLAN

RAIL TREE HILL ESTATES
VOSE HILL ROAD

WESTFORD, MA
Prepared For
THE TOWN OF WESTFORD
55 MAIN STREET
WESTFORD, MA 01886

Marchionda

& Associates, L.P.



Engineering and
Planning Consultants

62 Montvale Avenue
Suite I
Stoneham, MA 02180
TEL: (781) 438-6121
FAX: (781) 438-9654
Email: engineering@marchionda.com
Website: www.marchionda.com

DATE: 12/03/09

\\PROJECTS\782-01 VOSE HILL WESTFORD

M. & A. NO. 782-01

SCALE: 1"=80'

SHEET 1 OF 2